

14681 S. Prairie Ave.

DEPARTMENT OF COUNTY ENGINEER
DIVISION OF BUILDING AND SAFETY
COUNTY OF LOS ANGELES

WILLIAM J. FOX, COUNTY ENGINEER
CASBATT D. GRIFFIN, SUPT. OF BUILDING

SEWER—SEWAGE DISPOSAL
PERMIT APPLICATION

1

FOR APPLICANT TO FILL IN

BUILDING ADDRESS 14681 So. Prairie ave
LOCALITY Lemoor
NEAREST CROSS ST. 147th street
OWNER George Powell
MAIL ADDRESS 2545 E. 24th street
CITY L.A. TEL. NO. K. 9801
CONTRACTOR R. J. Dorale
ADDRESS 14425 So. Minnie
CITY Compton TEL. NO. Ne 2-3514
REGISTRATION NO. 94348 STATE COUNTY
LEGAL DESCRIPTION LOT NO. 7-849
BLOCK TRACT Tamondale Acres
SIZE OF LOT NO. OF BLDGS. NOW ON LOT 1
USE OF BUILDINGS Service Station

NO.	DESCRIPTION OF WORK	FEE
✓	HOUSE SEWER CONNECTING TO PUBLIC SEWER	@ \$ 3.50 350
	HOUSE SEWER CONNECTING TO PRIVATE DISPOSAL SYSTEM	1.00
	CONNECT ADDITIONAL BLDG. OR WORK TO HOUSE SEWER	1.00
	ALTER OR REPAIR EXISTING SEWER OR DISPOSAL SYSTEM	1.00
	DISCONNECT AND ABANDON SEWER AND/OR DISPOSAL SYSTEM	1.00
	SEPTIC TANK, SEEPAGE PIT OR PITS AND/OR DRAINFIELD	2.00
	CESSPOOL—DRYWELL SPECIAL CONDITIONS ONLY	2.00

OWNERS AUTHORIZATION	PERMIT	\$	1	00
	TOTAL FEE		4	50

I HAVE THIS DATE CONTRACTED WITH THE HEREIN NAMED CONTRACTOR TO CONNECT THE ABOVE DESCRIBED EXISTING DWELLING TO THE PUBLIC SEWER

SIGNED THIS _____ DAY OF _____ 19_____

OWNER OR OWNERS AGENT _____
ADDRESS _____

I HEREBY ACKNOWLEDGE THAT I HAVE READ THIS APPLICATION AND STATE THAT THE ABOVE IS CORRECT AND AGREE TO COMPLY WITH ALL COUNTY ORDINANCES AND STATE LAWS REGULATING PLUMBING AND SEWERS.
I HEREBY CERTIFY THAT I AM PROPERLY REGISTERED AND/OR LICENSED AS REQUIRED BY LOS ANGELES COUNTY AND STATE OF CALIFORNIA OR THAT I AM THE LEGAL OWNER OF THE ABOVE DESCRIBED RESIDENTIAL PROPERTY.


SIGNATURE OF PERMITTEE R. J. Dorale

BUILDING ADDRESS 14681 So PRAIRIE
LOCALITY LEMOOR
NEAREST CROSS ST. 147th ST
DISTRICT NO. 7-60 SERIAL NO. A 12399 PERMIT NO. 9946 S
RECEIVED BY Kyates Ready for Inspection DATE ISSUED 6/12/53
USE ZONE OCCUPANCY RES MAP BK PG
CHARGES REIMBURSEMENT FEE
REQUIRED NOT REQUIRED
JOB NO. CONNECTION CHARGE FEE
CO. IMP. NO. 1471-3
RECEIPT NO. DATE BY
WAIVER FOR RECORDING
RECEIPT NO. DATE BY
TRUNK PERMIT NO.
ROAD PERMIT NO.
STATE ENCROACHMENT PERMIT NO.
INDUSTRIAL WASTE APPROVAL DOMESTIC USE ONLY BY 10/30 DATE 6-12-53
CONNECTION DATA
STATION 14+39.0 DEPTH 5'
MANHOLE REFERENCE UPPER 112.2' N LOWER
TYPE OF CONNECTION CURB P.L. LENGTH FROM M.L. TO P.L. 6'
APPROVALS INSPECTOR'S SIGNATURE DATE
NEW HOUSE SEWER M. Lead 6/17/53
CONNECT ADDITIONAL BUILDING OR WORK
SEPTIC TANK, SEEP. PIT(S) AND/OR DRAINFIELD
CESSPOOL DRYWELL
ALTER, REPAIR SEWER SEWAGE DISPOSAL SYSTEM
DISCONNECT PLUG AND ABANDON HOUSE SEWER
BACKFILL SEPTIC TANKS
SEEP. PIT(S) CESSPOOLS

FOR OFFICE USE

REQUIRED INFORMATION

1. INDICATE ALL BUILDINGS ON PROPERTY.
2. INDICATE AND DIMENSION SEWAGE DISPOSAL SYSTEM WITH TIE DISTANCES TO BUILDINGS AND PROPERTY LINES.
3. INDICATE NORTH DIRECTION ON PLOT.
4. INDICATE BOTH STREETS IF CORNER.

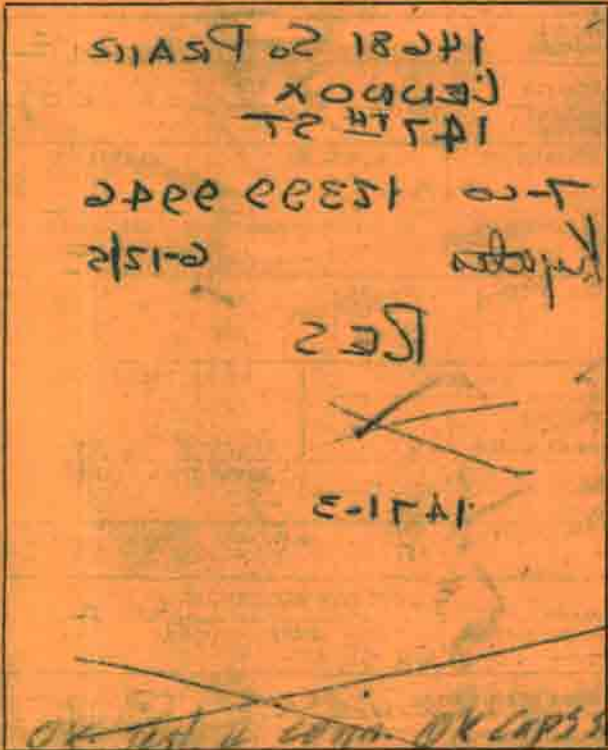

STREET AVE.

LEGAL DESCRIPTION

0.0511
 14281
 145th St

FIELD NOTES